

General Notes
 Do not scale off this drawing for construction purposes
 All dimensions and heights to be confirmed on site prior to commencement




ELEVATION/SECTION OF SCREEN AND FRONT DOORS




ELEVATION FACING BREWERY YARD



Broxtowe Borough Council
 Planning & Community Development
 12 OCT 2017

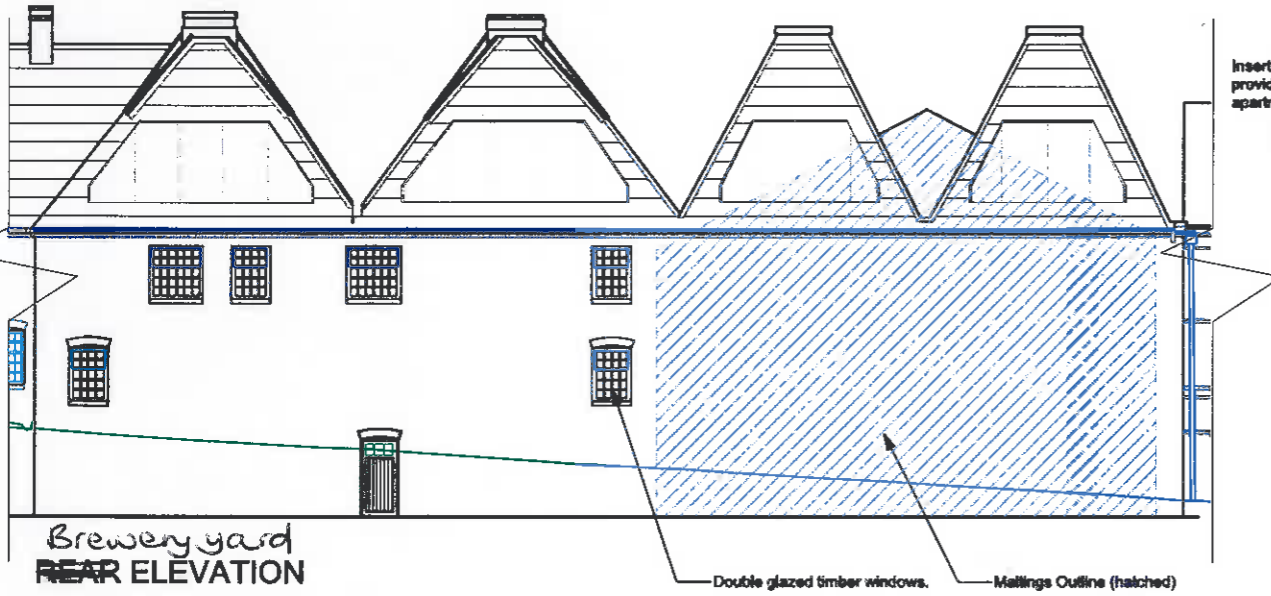

Brewery yard
 REAR ELEVATION

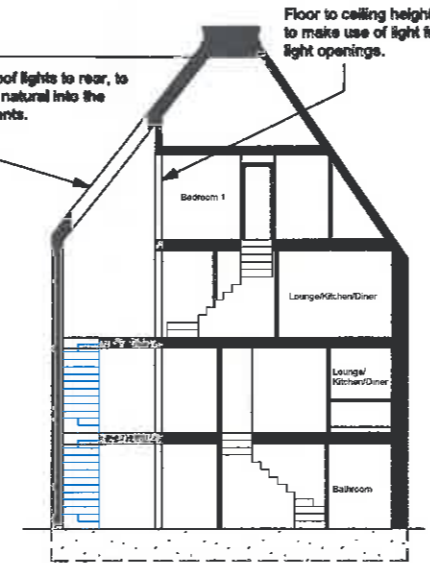

SECTION - BB

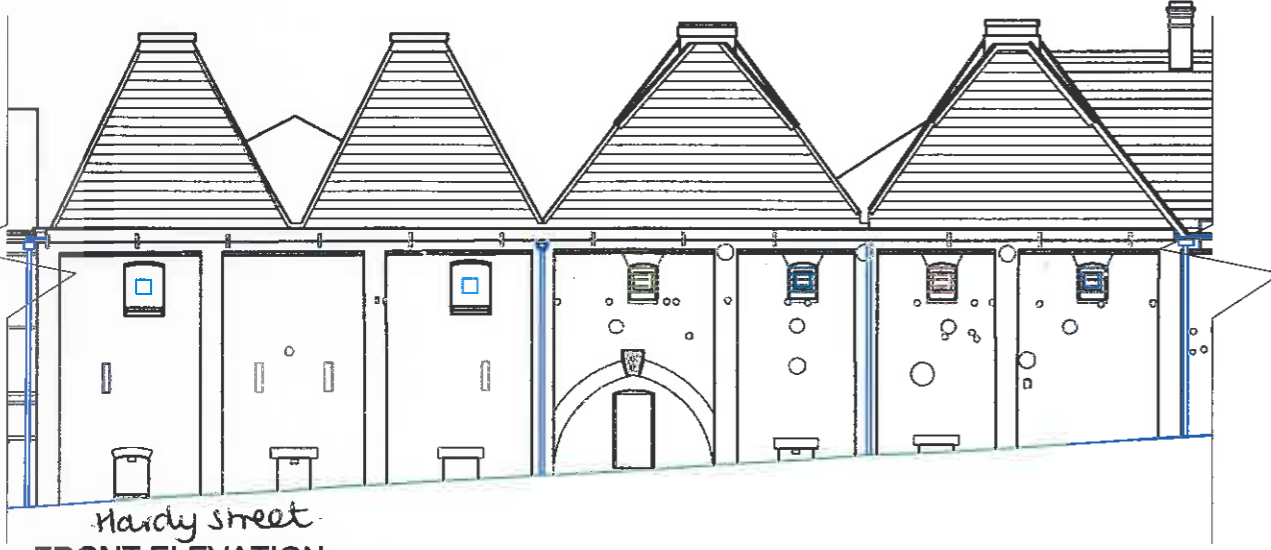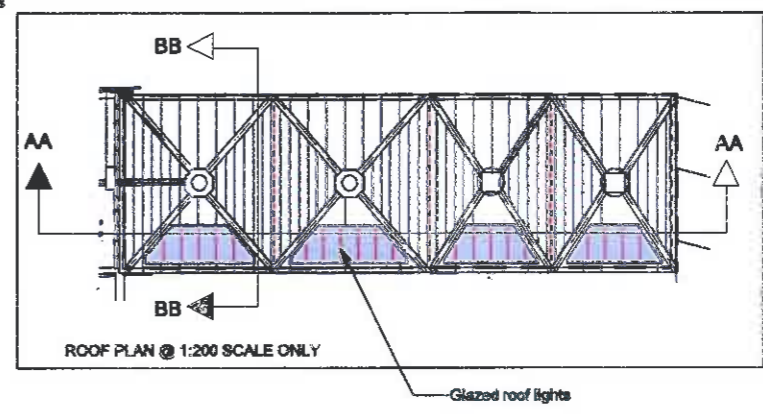

Hardy street
 FRONT ELEVATION



SECTION - AA

PROPOSED ELEVATIONS AND SECTIONS

PLANNING

A: 09-10-17 Amended street title
 0: 14-09-17 First Issue
 Revisions

fairgrove
 GALTEE HOUSE
 1 HEANOR ROAD ILKESTON DERBYSHIRE DE7 8DY
 T: 0115 944 8700 F: 0115 9448701 WWW: fairgrove.co.uk

Project
 KIMBERLEY BREWERY
 REDEVELOPMENT
 HARDY STREET, KIMBERLEY
 THE KILNS

Drawing title
 PROPOSED ELEVATIONS
 & SECTIONS

Preliminary	For Construction	As Built
Planning Issue	Building Reg. Issue	Contract Issue

© The contents of this drawing may not be reproduced in whole or in part without the written permission of Fairgrove Homes Limited

Scale	Date	Drawn by	Checked by
1:200@A3	SEPT17	CS	

Job No.	Dwg. No.	Rev.
058	PLK/207	A

©copyright